

T.M. ARCHITECTURAL SERVICES

DATE	ISSUE
8/1/2024	STRUCTURAL COORD.

STRUCTURAL COORDINATION

JULY 25, 2024


DESIGN DRAWING
NOT FOR CONSTRUCTION

PROJECT: 2401


STONE CREEK
CONDOMINIUMS
AS-BUILT

760 W. BEAVER
CREEK BLVD
AVON, CO 81620
MAIN LEVEL PLAN & GARAGE
SECTION

A-101

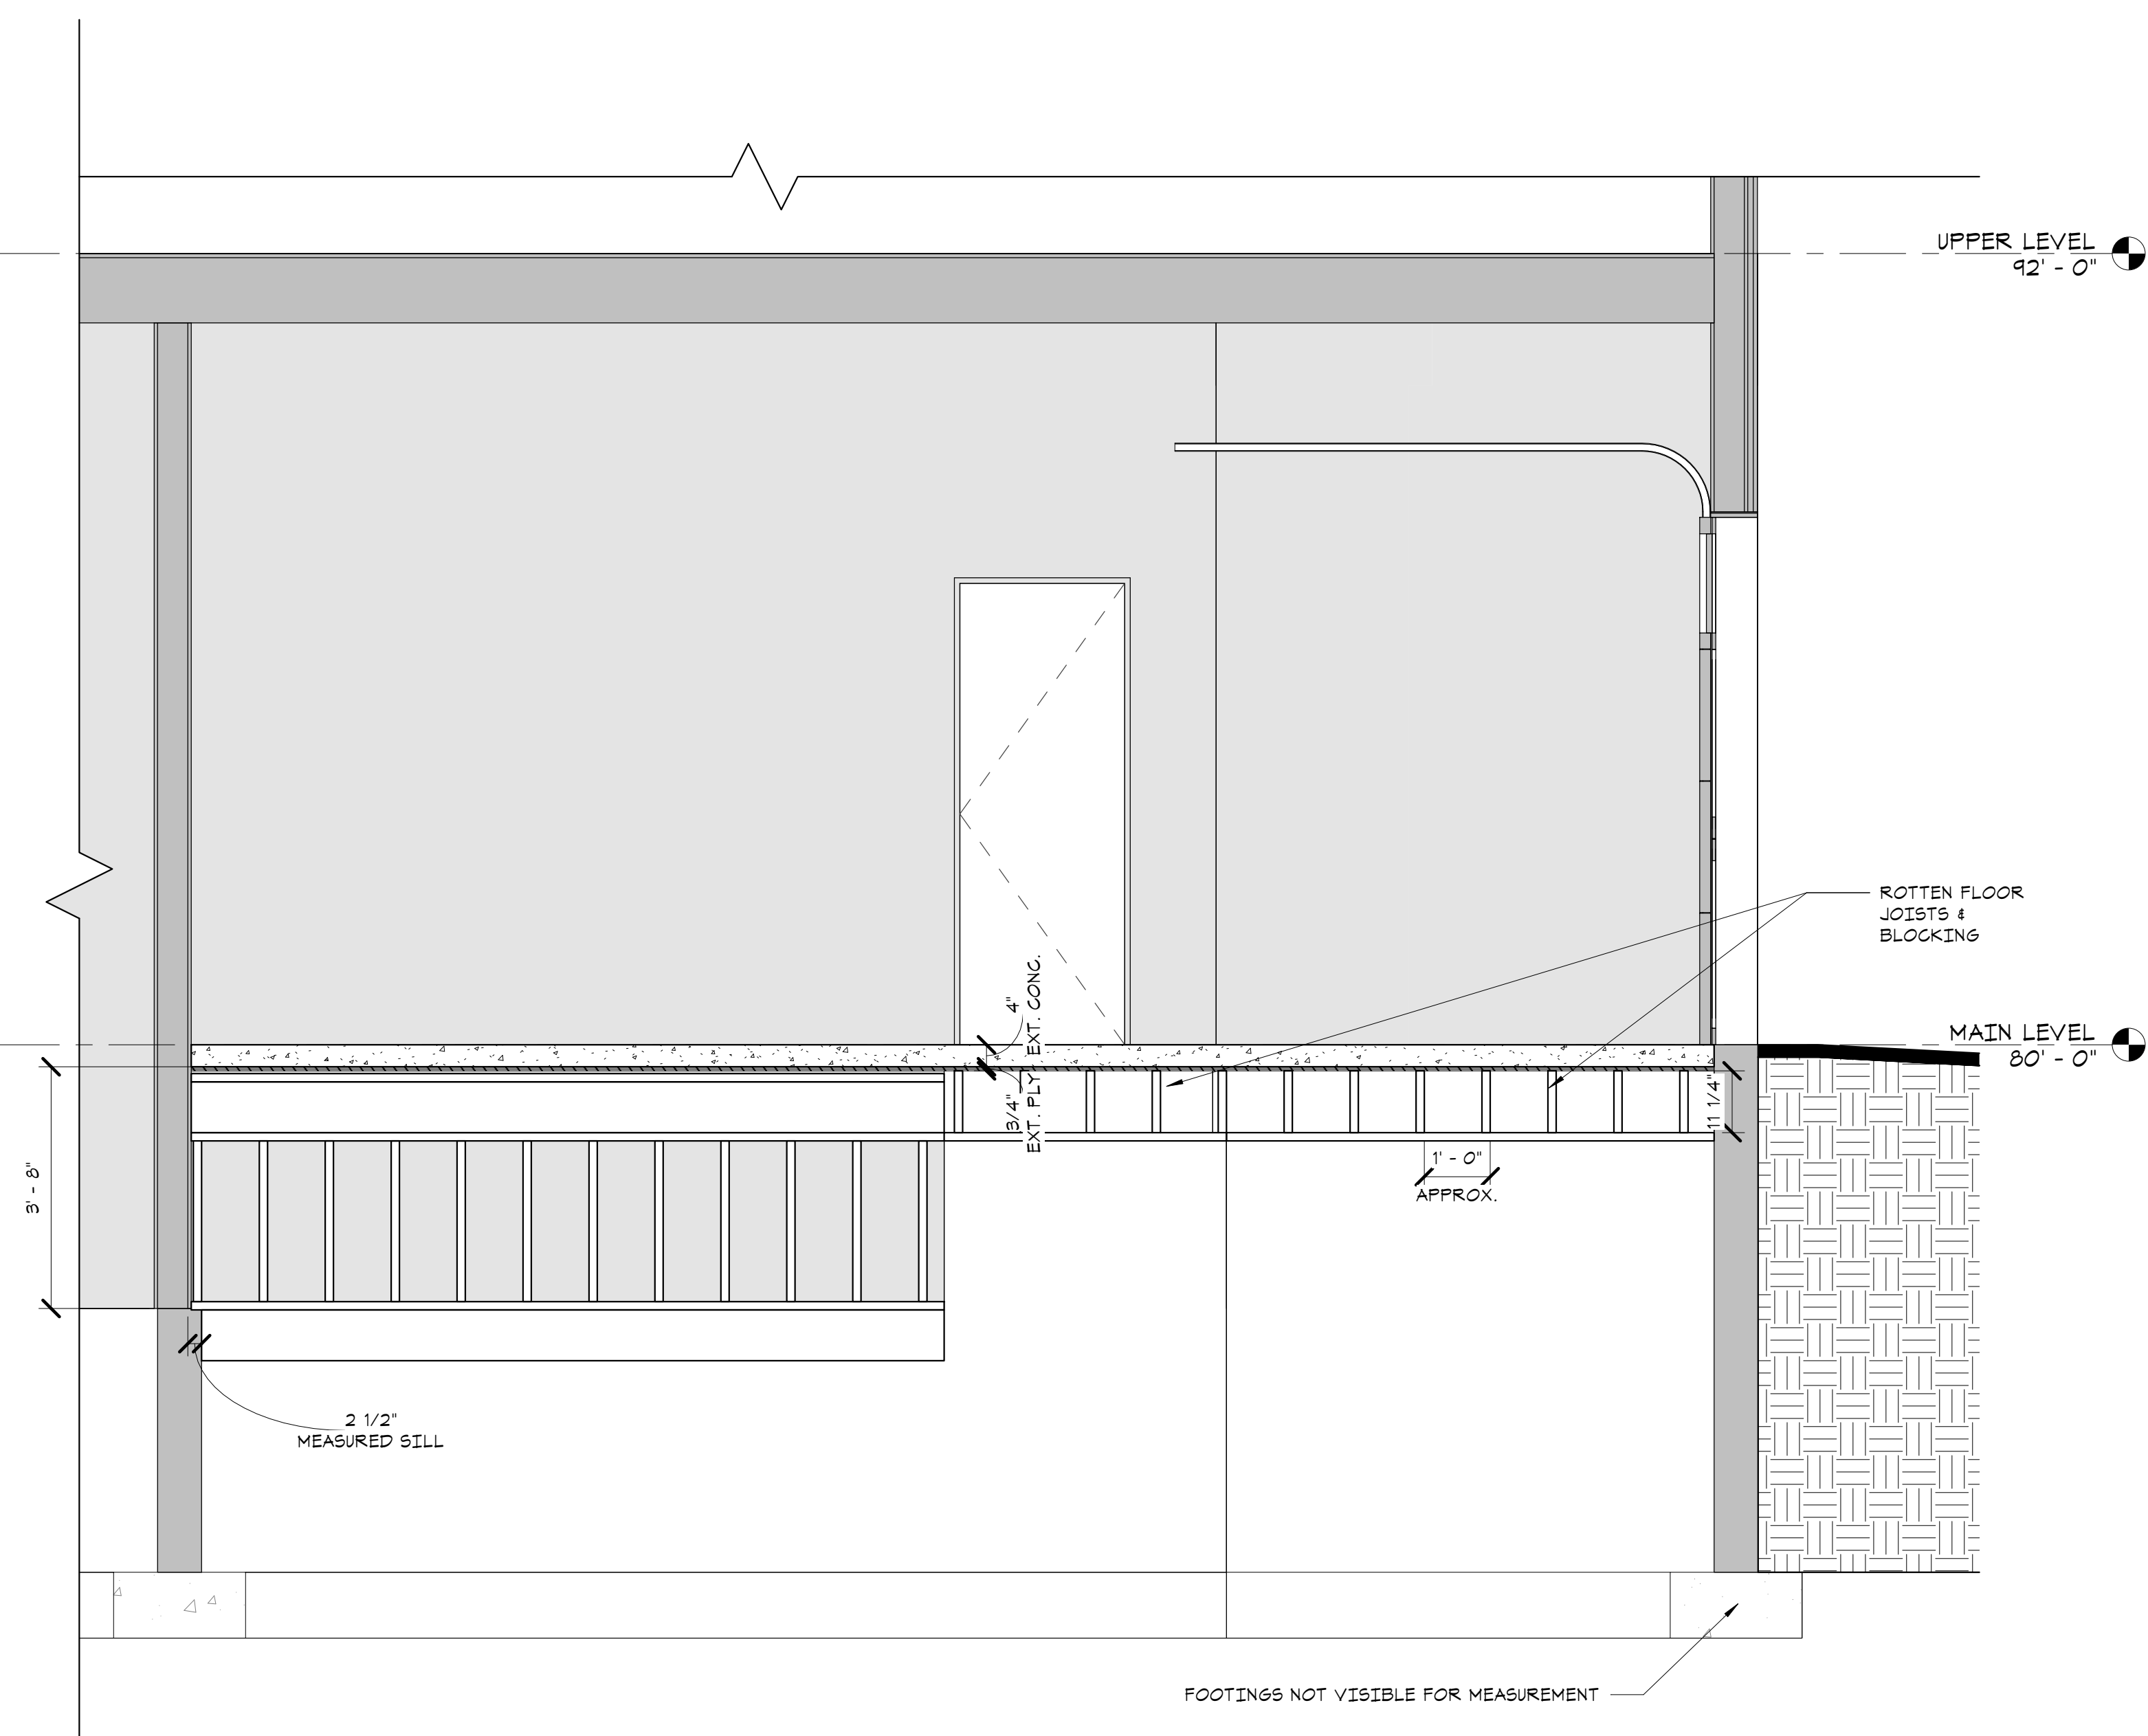

2 GARAGE SECTION
SCALE: 1/2" = 1'-0"

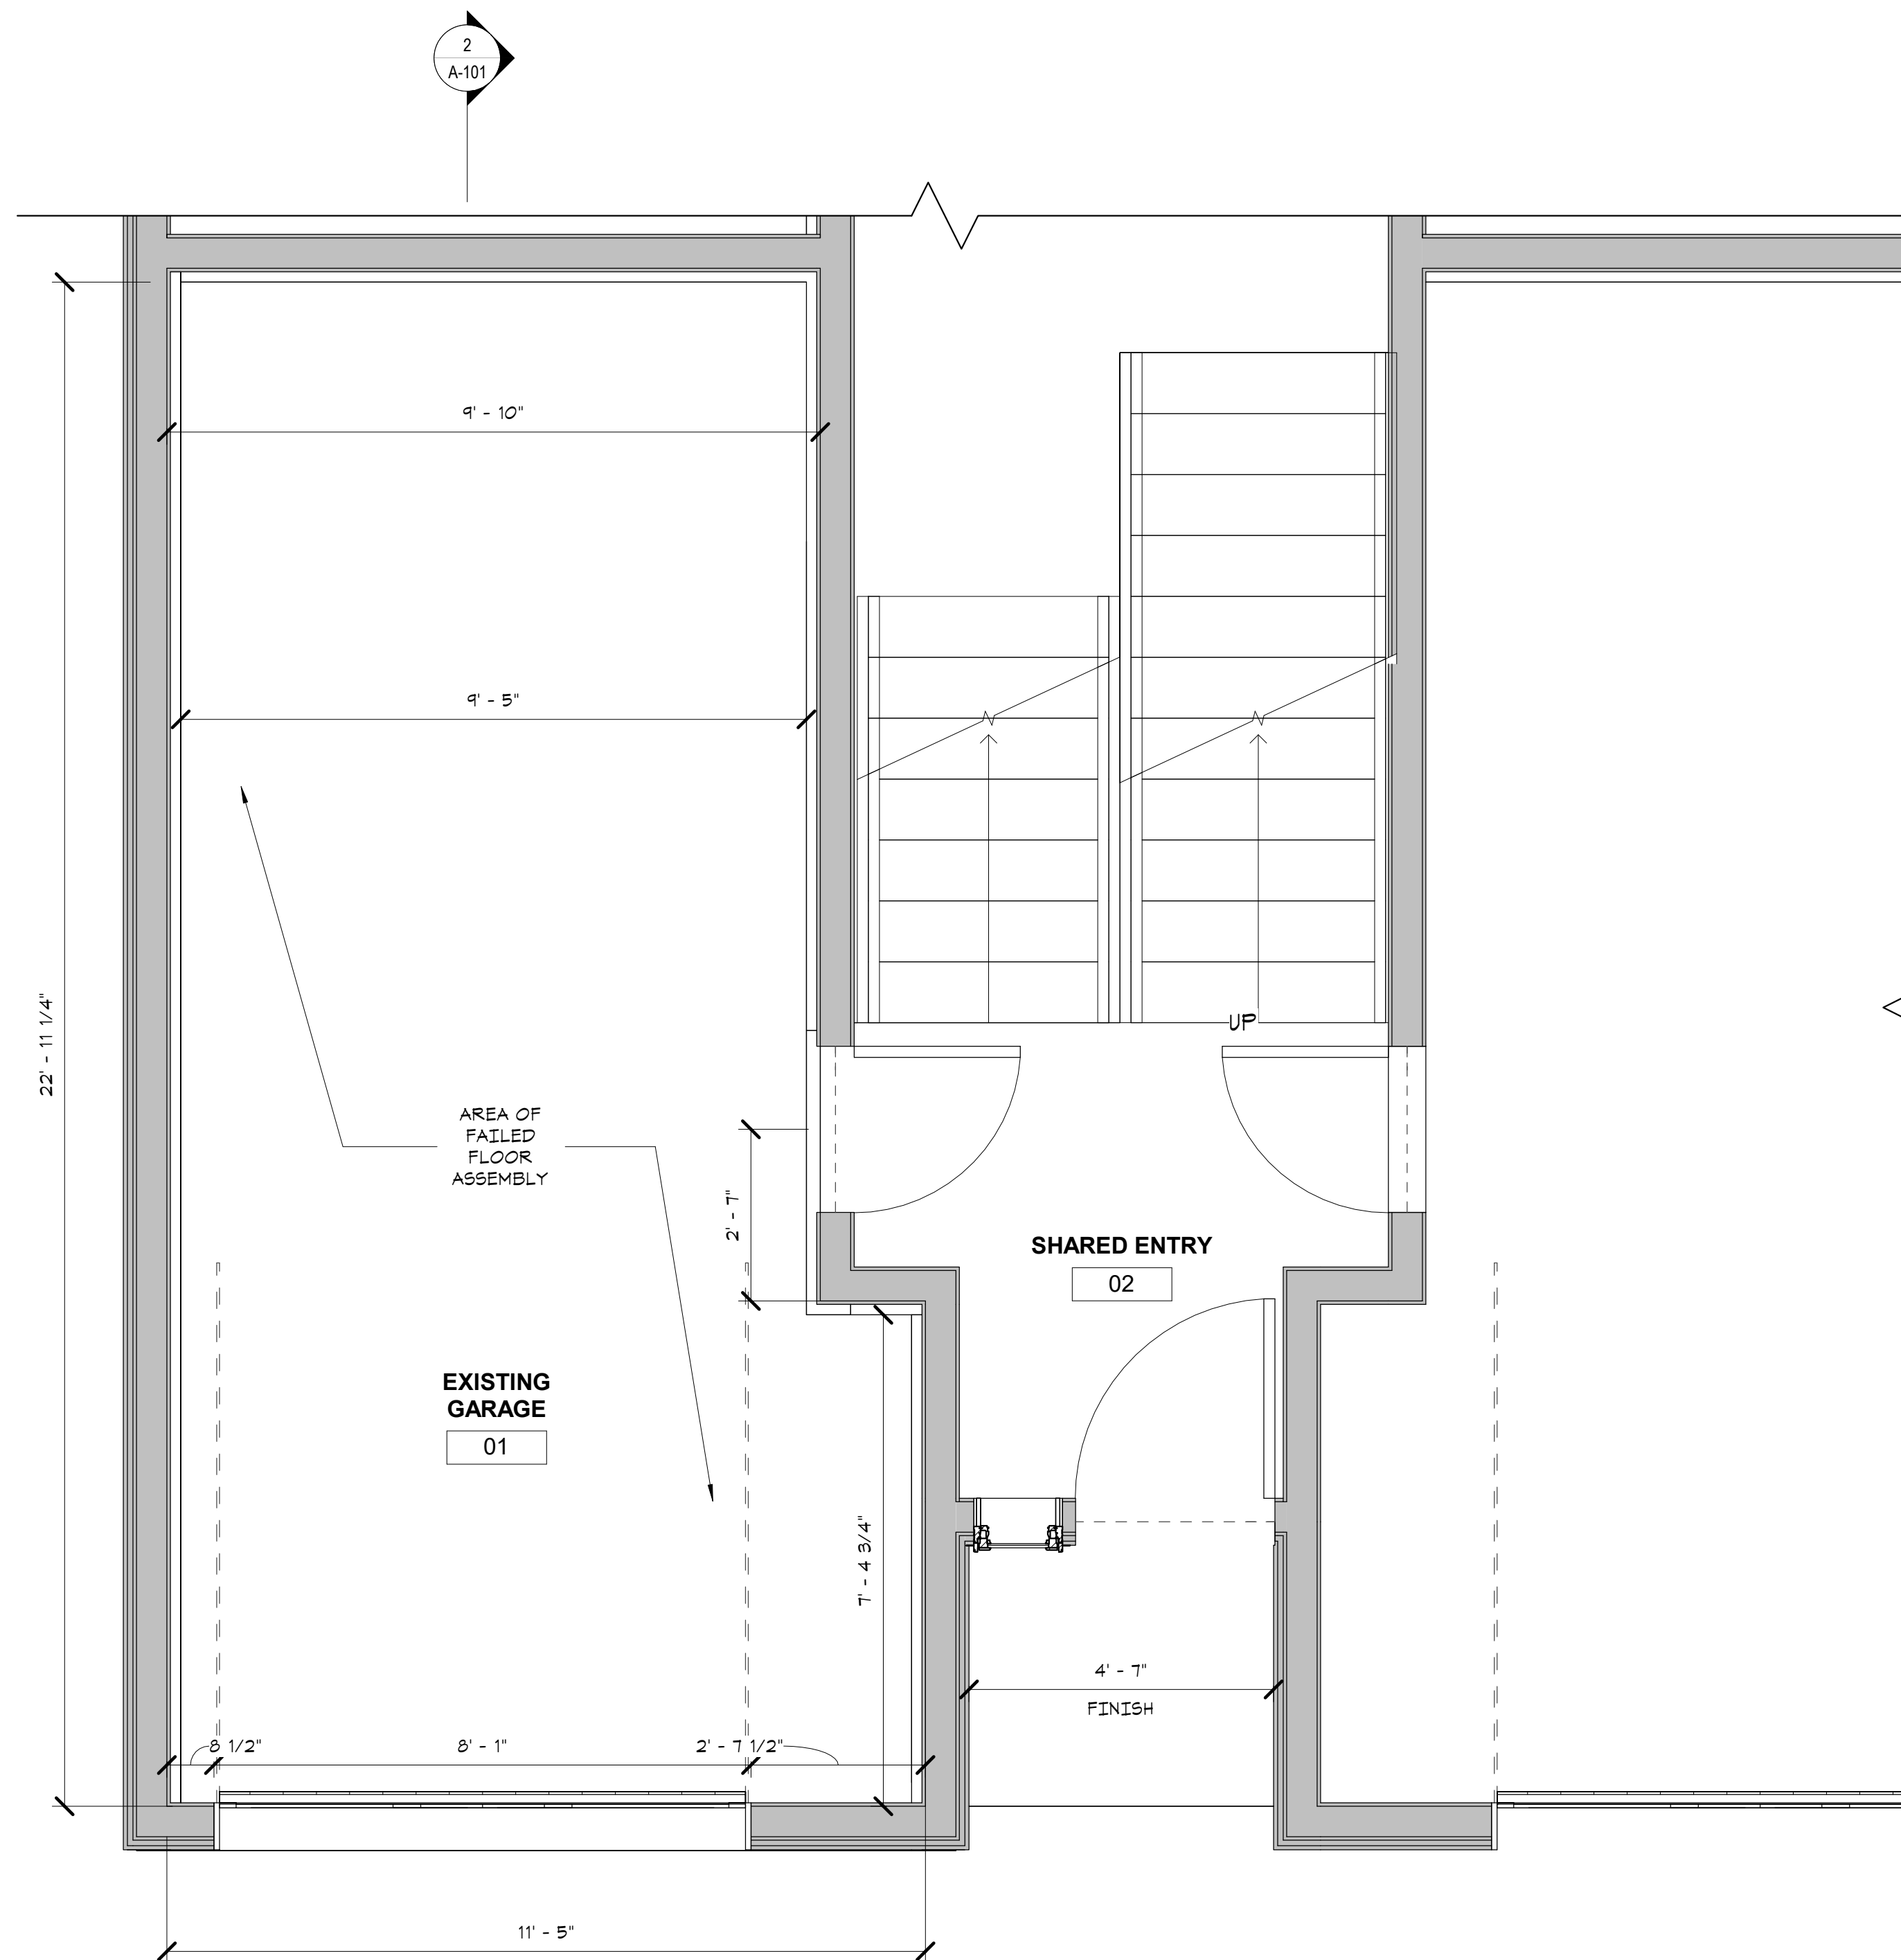

1 MAIN LEVEL PLAN
SCALE: 1/2" = 1'-0"

